


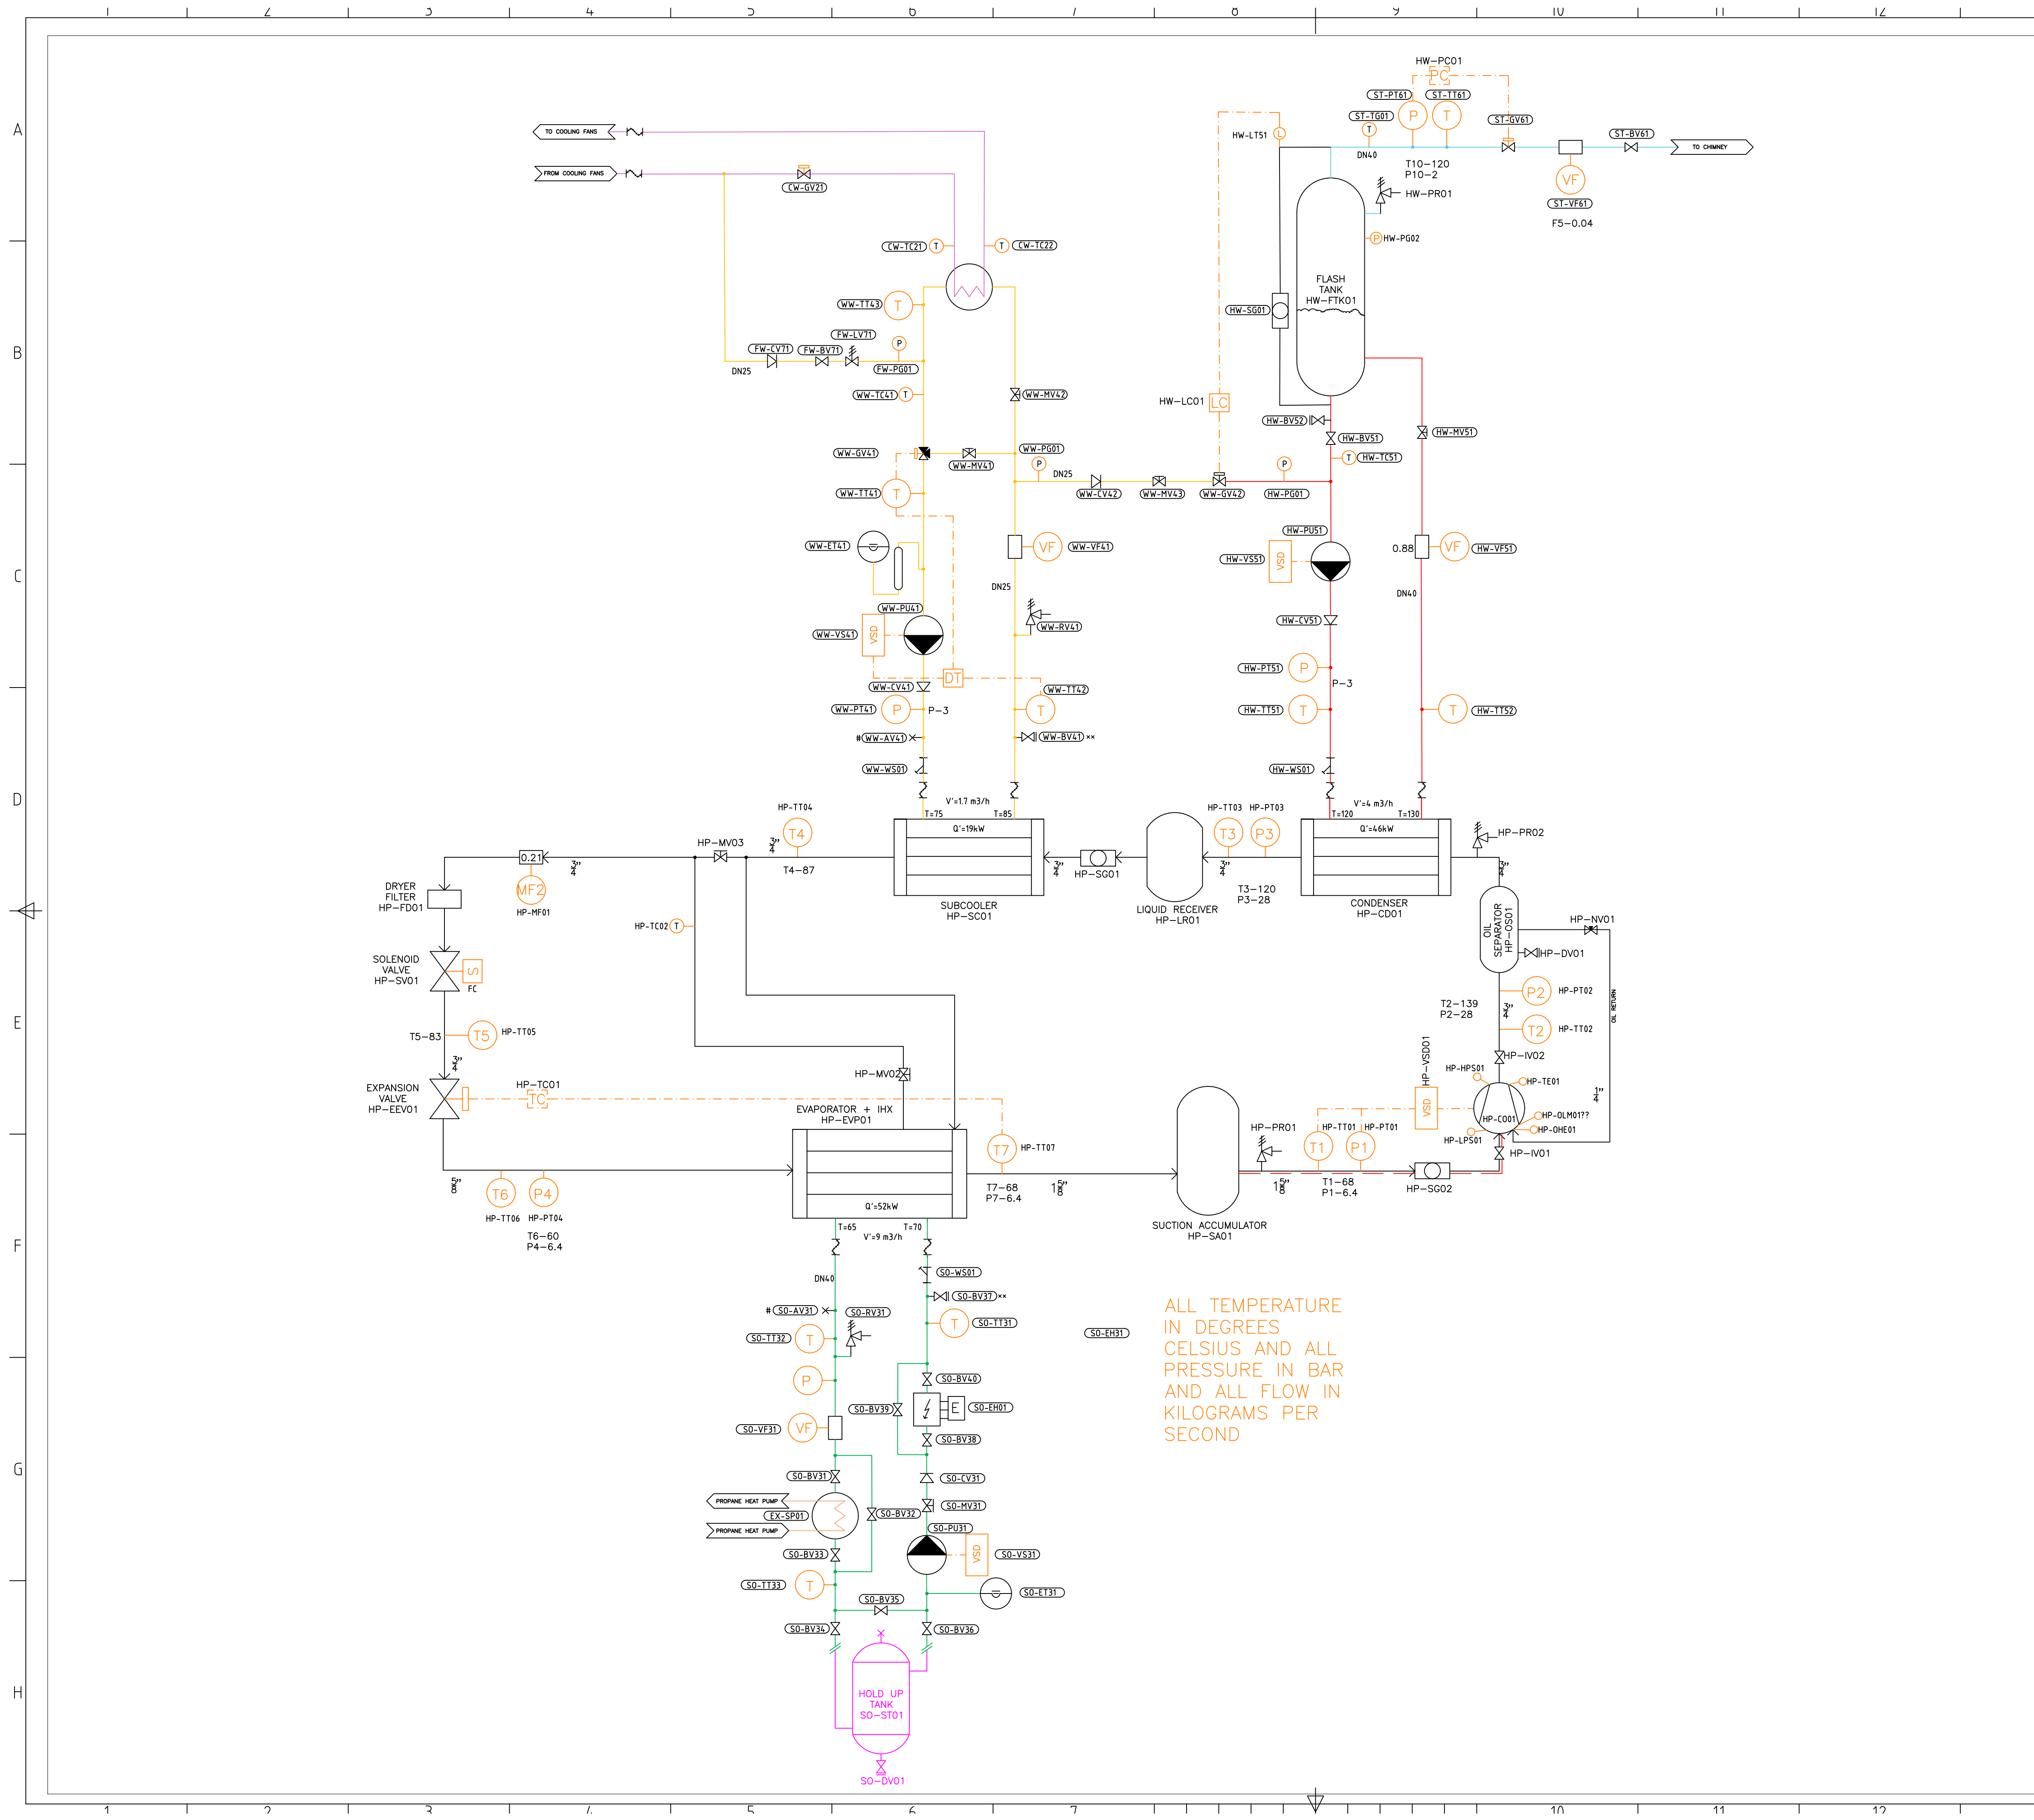

RevNo	Revision note	Date	Signature	Checked
22	UPDATES REFLECTING HP AS BUILT CONDITION	27/7/26	KH	

Legend electric heaters									
Make: 18/02/2026									
Nr.	Loop:	Type	Power	pressure	Control	Signal	Temp.	Fluid	Comment
SC-EH01	Source	Imm	45	10	Imm	Imm	20/120	Water	

Legend Circulation pumps									
Make: tbd									
Nr.	Loop:	Type	Power	pressure	Control	Signal	Temp.	Fluid	Comment
SC-P01	Source	Imm	75	10	Imm	Imm	20/120	Water	

Legend Control valves									
Make: tbd									
Nr.	Loop:	Type	Power	pressure	Control	Signal	Temp.	Fluid	Comment
SC-CV01	Source	Imm	75	10	Imm	Imm	20/120	Water	

Legend Ball valves									
Make: tbd									
Nr.	Loop:	Type	Power	pressure	Control	Signal	Temp.	Fluid	Comment
SO-BV31	Source	Imm	75	10	Imm	Imm	20/120	Water	

Legend Manual Balancing Valves									
Make: tbd									
Nr.	Loop:	Type	Power	pressure	Control	Signal	Temp.	Fluid	Comment
SO-MV31	Source	Imm	75	10	Imm	Imm	20/120	Water	

Legend Check Valves									
Make: 18/02/2026									
Nr.	Loop:	Type	Power	pressure	Control	Signal	Temp.	Fluid	Comment
SO-CV31	Source	Imm	75	10	Imm	Imm	20/120	Water	

Legend air vent valves									
Make: Giacomini									
Nr.	Loop:	Type	Power	pressure	Control	Signal	Temp.	Fluid	Comment
SO-AV31	Source	Imm	75	10	Imm	Imm	20/120	Water	

Legend Pressure limiting valve									
Make: APEX									
Nr.	Loop:	Type	Power	pressure	Control	Signal	Temp.	Fluid	Comment
FW-LV71	Source	Imm	75	10	Imm	Imm	20/120	Water	

Legend Pressure Relief (Safety Valves) valves									
Make: tbd									
Nr.	Loop:	Type	Power	pressure	Control	Signal	Temp.	Fluid	Comment
SO-PR31	Source	Imm	75	10	Imm	Imm	20/120	Water	

Legend Expansion Tanks									
Make: tbd									
Nr.	Loop:	Type	Power	pressure	Control	Signal	Temp.	Fluid	Comment
SO-ET31	Source	Imm	75	10	Imm	Imm	20/120	Water	

Legend for Pipe, Bend, Junction, Access									
Make: tbd									
Nr.	Loop:	Type	Power	pressure	Control	Signal	Temp.	Fluid	Comment
SO-P01	Source	Imm	75	10	Imm	Imm	20/120	Water	

THE UNIVERSITY OF
WAIKATO
Te Whare Wānanga o Waikato

AHUORA
CENTRAL FOR SMART ENERGY SYSTEMS

Designed by JO	Checked by	Approved by - date	Filename	Date 27/7/2026	Scale
Notes: # Indicative location, actually in highest physical point ** Indicative location, actually in lowest physical point --- Heat Tracing					STEAM GEN HEAT PUMP Edition 22 Sheet 1